

ADD2018-00058
River hall

From: [Karla Llanos](#)
To: ["Rodriguez, Anthony"](#)
Cc: ["Rodriguez, Anthony"](#); ["Russell Schropp"](#); [Carl A. Barraco](#); [Jennifer Sapen](#)
Bcc: [File](#)
Subject: RE: ADD2018-00058 River Hall Insufficiency Response
Date: Wednesday, May 30, 2018 8:56:00 AM
Attachments: [21988-MCP 2018-05-29.pdf](#)

Good Morning Mr. Rodriguez,

Please accept this email as a response to your insufficiency comments dated May 25, 2018.

- 1. The submitted Master Concept Plan contains three pages, whereas the previously approved Master Concept Plan contains five pages. The submitted MCP appears to omit some cross sections approved as part of the previously approved MCP. Please review and revise the MCP to be consistent with the previously approved MCP to the extent that it is not being amended by this request.*

Response: The two missing sheets have been added to the MCP. The MCP remains consistent with the previously approved MCP. The purpose of the request is to update language in the resolution and add a small notation on the MCP indicting the traffic signal is existing. No modifications to the MCP have taken place other than the proposed. Please see the revised MCP attached.

- 2. Please revise the references to the specific conditions of Resolution Z-05-051 on the MCP to ensure that these references also incorporate references the conditions of Resolution Z-15-003 where applicable.*

Response: As previously discussed, the purpose of the request is to update language in the resolution. The references to the specific conditions of Resolution Z-05-051 on the MCP will remain and no modifications to the MCP have taken place other than the proposed.

Sincerely,

Karla Llanos

RECEIVED
MAY 30 2018

COMMUNITY DEVELOPMENT

ADD2018-00058

Planner
Barraco and Associates, Inc.
Civil Engineers ~ Land Surveyors ~ Land Planners
2271 McGregor Boulevard, Suite 100
Fort Myers, FL 33901
(239) 461-3170 Phone
(239) 461-3169 Fax
<http://www.barraco.net>

[Enclosure: Revised MCP]

File: 22955

From: Rodriguez, Anthony [mailto:ARodriguez4@leegov.com]
Sent: Friday, May 25, 2018 1:55 PM
To: Karla Llanos <karlal@barraco.net>
Subject: RE: ADD2018-00058 River Hall Email 2 of 2

Karla:

I am continuing to work through the above-referenced ADD request. Can you please address the following:

1. The submitted Master Concept Plan contains three pages, whereas the previously approved Master Concept Plan contains five pages. The submitted MCP appears to omit some cross sections approved as part of the previously approved MCP. Please review and revise the MCP to be consistent with the previously approved MCP to the extent that it is not being amended by this request.
2. Please revise the references to the specific conditions of Resolution Z-05-051 on the MCP to ensure that these references also incorporate references the conditions of Resolution Z-15-003 where applicable.

Please feel free to call or email with any questions you may have.

Thank you,

Anthony

RECEIVED
MAY 30 2018

COMMUNITY DEVELOPMENT

ADD 2018-00058

Anthony R. Rodriguez, AICP
Planner, Principal
Lee County Community Development Department
Zoning Section
PO Box 398
Fort Myers, FL 33902-0398
(239) 533-8786
arodriguez4@leegov.com

Please note: Florida has a very broad public records law. Most written communications to or from County Employees and officials regarding County business are public records available to the public and media upon request. Your email communication may be subject to public disclosure.

Under Florida law, email addresses are public records. If you do not want your email address released in response to a public records request, do not send electronic mail to this entity. Instead, contact this office by phone or in writing.

From: Karla Llanos [<mailto:karlal@barraco.net>]
Sent: Wednesday, May 16, 2018 12:08 PM
To: Rodriguez, Anthony
Subject: ADD2018-00058 River Hall Email 2 of 2

NOTICE: This email came from outside Lee County Government (leegov.com); exercise caution with attachments or links.

Anthony,

Here is email 2 of 2.

Thanks again.

Sincerely,

Karla Llanos

Planner
Barraco and Associates, Inc.
Civil Engineers ~ Land Surveyors ~ Land Planners
2271 McGregor Boulevard, Suite 100
Fort Myers, FL 33901
(239) 461-3170 Phone
(239) 461-3169 Fax

RECEIVED
MAY 30 2018

COMMUNITY DEVELOPMENT

ADD2018-00058

<http://www.barraco.net>

File: 22955

In order to use electronic files provided by Barraco and Associates, Inc. you must agree to the following:

In accepting and utilizing any drawings or other electronic data provided by Barraco and Associates, Inc., the recipient agrees that all such drawings and data are instruments of service of Barraco and Associates, Inc. who shall be deemed the author of the drawings and data, and shall retain all common law, statutory and other rights, including copyrights. Any inconsistencies the recipient discovers will be reported to Barraco and Associates, Inc. and will be corrected by Barraco and Associates, Inc.

The recipient accepts responsibility for confirming with Barraco and Associates, Inc. that the electronic file is current at the time of use by the recipient. The recipient also agrees to hold Barraco and Associates, Inc. harmless for any cost or damages incurred due to the recipient's use of an outdated electronic file and for any costs associated with updating the recipient's electronic files in the event of future revisions by Barraco and Associates, Inc.

The recipient agrees not to use these drawings and data, in whole or in part, for any purpose or project other than the project which is the subject of this agreement, nor shall the recipient provide that attached data to any other party not indicated as a recipient in the "To" field of this message. The recipient agrees to waive all claims against Barraco and Associates, Inc. resulting in any way from any unauthorized changes or reuse of the drawings and data for any other project by anyone other than Barraco and Associates, Inc.

In addition, the recipient agrees, to the fullest extent permitted by law, to indemnify and hold Barraco and Associates, Inc. harmless from any damage, liability or costs, including reasonable attorney fees and costs of defense, arising from any changes made by anyone other than Barraco and Associates, Inc. or from any reuse of the drawings and data without the prior written consent of Barraco and Associates, Inc.

RECEIVED
MAY 30 2018

COMMUNITY DEVELOPMENT

ADD2018-00058

MASTER CONCEPT PLAN
FOR

RIVER HALL RPD / CPD

(FORMERLY KNOWN AS HAWKS HAVEN RPD)

PROJECT DATA

SITE ADDRESS HAWK'S HAVEN DEVELOPERS, LLC 2401 RIVER HALL PARKWAY ALVA, FLORIDA 33920 (239) 274-0321 (239) 274-0517	PROJECT DATUM FLORIDA STATE PLANE WEST ZONE (NAD1983/90) NATIONAL GEODETIC VERTICAL DATUM (NGVD) 1929																				
ZONING HAWK'S HAVEN RPD	RECORD PLAT APPROVED																				
FLOOD ZONE ACCORDING TO F.I.R.M. COMMUNITY PANEL 125124 0250B, EFFECTIVE SEPTEMBER 19, 1984, THE SUBJECT PARCEL IS LOCATED IN FLOOD ZONE A7 (EL. 8) AND ZONE B.	STRAP NUMBERS																				
PERMIT REQUIREMENTS																					
AGENCY S. FLORIDA WATER MANAGEMENT DISTRICT LEE COUNTY DEVELOPMENT ORDER LEE COUNTY DEPARTMENT OF HEALTH FLORIDA DEPT. OF ENVIRONMENTAL PROTECTION F.D.O.T. CONNECTION PERMIT F.D.O.T. DRAINAGE CONNECTION PERMIT F.D.O.T. UTILITY PERMIT ARMY CORPS OF ENGINEERS F.D.E.P. NOTICE OF INTENT	<table><tr><td>STATUS</td><td>NOTES</td></tr><tr><td>APPROVED</td><td>PERMIT NO. 36-04006-P</td></tr><tr><td>APPROVED</td><td>PERMIT NO. DOS2004-00138</td></tr><tr><td>APPROVED</td><td>PERMIT NO. 0125120-117 DSGP</td></tr><tr><td>APPROVED</td><td>PERMIT NO. 47040-084-DWC</td></tr><tr><td>N/A</td><td>-</td></tr><tr><td>N/A</td><td>-</td></tr><tr><td>N/A</td><td>-</td></tr><tr><td>N/A</td><td>-</td></tr><tr><td>ISSUED</td><td>PERMIT NO. FLR10Y480</td></tr></table>	STATUS	NOTES	APPROVED	PERMIT NO. 36-04006-P	APPROVED	PERMIT NO. DOS2004-00138	APPROVED	PERMIT NO. 0125120-117 DSGP	APPROVED	PERMIT NO. 47040-084-DWC	N/A	-	N/A	-	N/A	-	N/A	-	ISSUED	PERMIT NO. FLR10Y480
STATUS	NOTES																				
APPROVED	PERMIT NO. 36-04006-P																				
APPROVED	PERMIT NO. DOS2004-00138																				
APPROVED	PERMIT NO. 0125120-117 DSGP																				
APPROVED	PERMIT NO. 47040-084-DWC																				
N/A	-																				
N/A	-																				
N/A	-																				
N/A	-																				
ISSUED	PERMIT NO. FLR10Y480																				

NOTE: CONTRACTOR MUST OBTAIN AND KEEP ON FILE A COPY OF ALL PERMITS
REQUIRED PRIOR TO COMMENCEMENT OF ANY CONSTRUCTION ACTIVITY


DESIGN TEAM

PROJECT ENGINEER CARL A. BARRACO, P.E.	PROJECT MANAGEMENT CHRIS VAN BUSKIRK
DESIGN ENGINEER TIM GAVIN, P.E.	PROJECT SURVEYOR SCOTT WHEELER, P.S.M.
LEAD DESIGN TECHNICIAN WES KAYNE, E.I.	SITE PLANNING JENNIFER SAPEN
DESIGN STAFF TOM R. HOLMLUND	LANDSCAPE DESIGN
QUALITY CONTROL TOM R. HOLMLUND	RECORD DRAWINGS


THESE PLANS MAY HAVE BEEN MODIFIED IN SIZE BY REPRODUCTION.
THIS MUST BE CONSIDERED WHEN OBTAINING SCALED DATA.

ALL DIMENSIONS ARE IN FEET.


PART OF SECTION 27, TOWNSHIP 43 SOUTH, RANGE 26 EAST
LEE COUNTY, FLORIDA

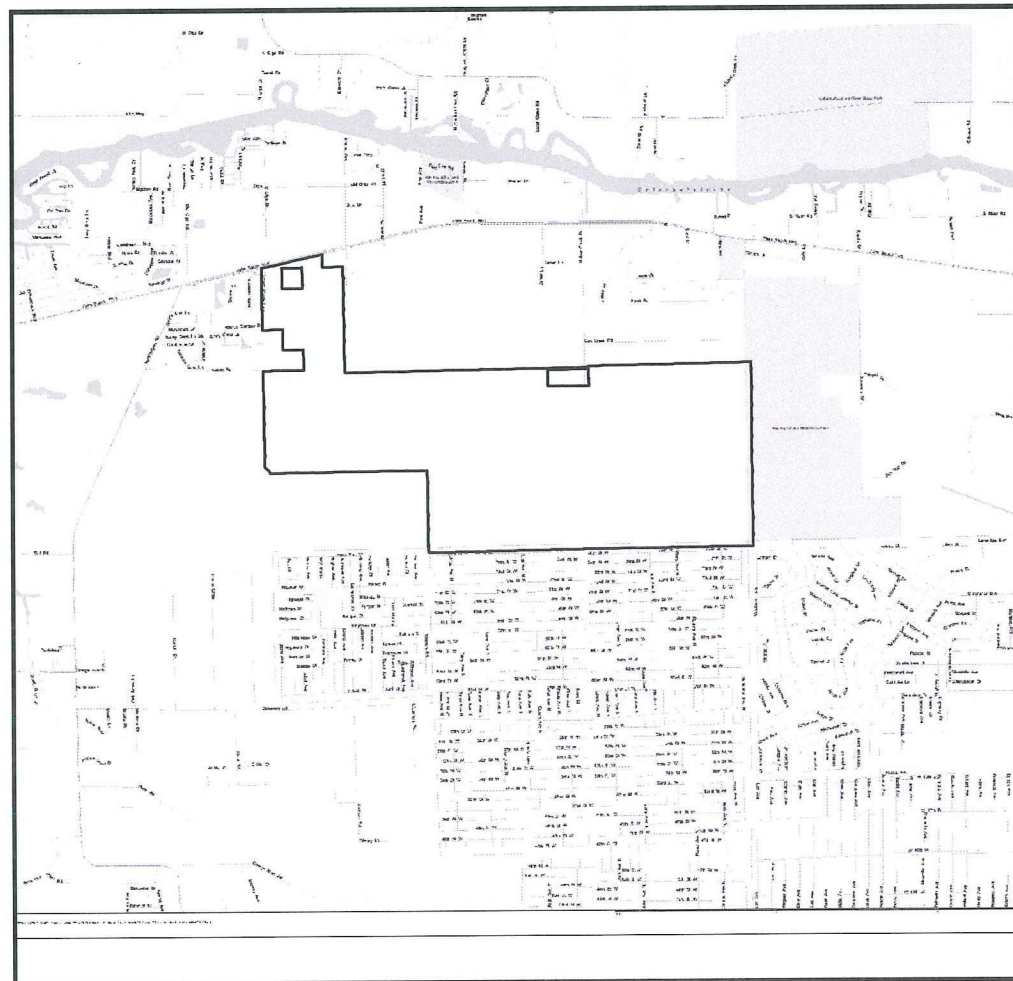

PROJECT
LOCATION

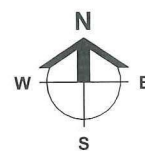

LOCATION MAP

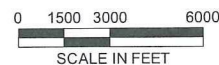

INDEX OF DRAWINGS

SHEET	DESCRIPTION	XREF	DRAWING NAME
1	COVER SHEET AND LOCATION MAP	A	21998Z01.DWG
2	MASTER CONCEPT PLAN	B	21998Z03.DWG
3	DETAILS	-	21998Z04.DWG

CROSS-REFERENCED DRAWINGS:

XREF NO.	DESCRIPTION	DRAWING NAME
A	LOCATION MAP - LEE COUNTY 43-26	LEEMAP.DWG
B	BASE LINEWORK PLAN	21988A00.DWG

RECEIVED
MAY 30 2018

COMMUNITY DEVELOPMENT
ADD2018-00058

Barraco
and Associates, Inc.
CIVIL ENGINEERING - LAND SURVEYING
LAND PLANNING - LANDSCAPE DESIGN
www.barraco.net
2271 MCGREGOR BLVD., SUITE 100
POST OFFICE DRAWER 2800
FORT MYERS, FLORIDA 33902-2800
PHONE (239) 461-3170
FAX (239) 461-3169
FLORIDA CERTIFICATES OF AUTHORIZATION
ENGINEERING 7995 - SURVEYING LB-6940

PREPARED FOR
**GREENPOINTE
COMMUNITIES,
LLC**
7807 BAYMEADOWS ROAD E
SUITE 205
JACKSONVILLE, FL 32256
PHONE (904) 562-1358
FAX (904) 996-2481

PROJECT DESCRIPTION
**RIVER
HALL**
FORMERLY KNOWN AS
HAWKS HAVEN
PART OF SECTIONS 27, 34, 35 AND 36
TOWNSHIP 43 SOUTH
RANGE 26 EAST
LEE COUNTY, FLORIDA

DRAWING NOT VALID WITHOUT SEAL, SIGNATURE AND DATE
© COPYRIGHT 2018, BARRACO AND ASSOCIATES, INC.
REPRODUCTION, CHANGES OR ASSIGNMENTS ARE PROHIBITED

FILE NAME: 21998Z01.DWG
LOCATION: J:\21988\DWG\ZONING\2018 REZONE\
PLOT DATE: TUE: 5-29-2018 - 4:07 PM
PLOT BY: ANGELICA HARDY

CROSS REFERENCED DRAWINGS
MASTER = BAI-COVER-1.DWG

PLAN REVISIONS	
3-20-13	REVISED AMENDMENT AREA
12-17-14	REVISED AMENDMENT AREA
1-23-15	
2-15-16	TRAFFIC SIGNAL ADDED
5-29-18	PER LEE COUNTY ADDED 2 SHEETS

PLAN STATUS

COVER SHEET
AND
LOCATION MAP

PROJECT / FILE NO.	SHEET NUMBER
.	1

OPEN SPACE CALCULATIONS:

ENTIRE PROJECT	
TOTAL DEVELOPMENT	1,978.44 ACRES
OPEN SPACE PROVIDED	1,175.00 ACRES
INDIGENOUS OPEN SPACE PROVIDED	465.04 ACRES

RPD	
TOTAL RPD DEVELOPMENT	1,951.39 ACRES
OPEN SPACE REQUIRED (40%)	780.56 ACRES
OPEN SPACE PROVIDED	1,167.95 ACRES
LAKES = 293.75 AC (25% OF 1,175.00 AC.)	
INDIGENOUS OPEN SPACE = 457.99 AC	
RECREATIONAL OPEN SPACE / GOLF COURSE = 408.94 AC	
OTHER OPEN SPACE 7.27 AC	


INDIGENOUS SPACE REQUIRED (50% OF 780.56)	390.28 ACRES
INDIGENOUS OPEN SPACE PROVIDED	457.99 ACRES

CPD	
TOTAL RPD DEVELOPMENT	27.05 ACRES
OPEN SPACE REQUIRED (20%)	5.41 ACRES
OPEN SPACE PROVIDED	7.05 ACRES
INDIGENOUS OPEN SPACE = 7.05 AC	

INDIGENOUS SPACE REQUIRED (50% OF 5.41)	2.71 ACRES
INDIGENOUS OPEN SPACE PROVIDED	7.05 ACRES

NOTES:

- OPEN SPACE AND INDIGENOUS AREAS TO BE PROVIDED FOR THE ENTIRE DEVELOPMENT WITHIN THE COMMON INDIGENOUS AND OPEN SPACE AREAS IN GENERAL ACCORDANCE WITH THOSE DEPICTED ON THE MASTER CONCEPT PLAN. INDIVIDUAL DEVELOPMENT PARCELS WILL BE RESPONSIBLE FOR SEPARATE OPEN SPACE IN ACCORDANCE WITH RESOLUTION Z-05-051 CONDITION 3I.
- GOLF COURSE AMENITIES AREA WILL BE LOCATED IN GOLF CLUB AREA LAND USE POD. (CLUB HOUSE, CART BARN, MAINTENANCE FACILITIES) THE 10 ACRES ALLOCATED FOR THESE USES IS NOT INCLUDED IN THE OPEN SPACE FOR THE GOLF COURSE / DRIVING RANGE AREA.

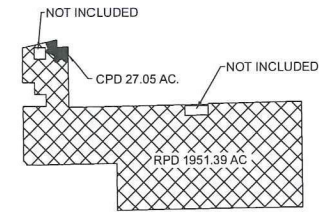


PROPOSED ZONING KEY MAP

DEVIATIONS:

- DEVIATION FROM SECTION 10-385(D)(3)A REQUIREMENT TO PROVIDE A MAXIMUM FIRE HYDRANT SPACING OF 800 FEET IN THE ONE- AND TWO-DWELLING UNIT AREA, TO ELIMINATE THIS REQUIREMENT IN AREAS ALONG THE "SPINE" ROAD WHERE NO HOMES EXIST.
- WITHDRAWN.
- DEVIATION FROM SECTION 10-329(D)(4) REQUIREMENT TO PROVIDE LAKE BANKS TO BE SLOPED 4:1, TO ALLOW BULKHEADS FOR UP TO 25 PERCENT OF THE SHORELINE OF LAKE BANKS.
- DEVIATION FROM SECTION 34-2194(B) REQUIREMENT TO PROVIDE A 25-FOOT SETBACK FROM BODIES OF WATER, TO ALLOW 20-FOOT SETBACKS FOR THE MANMADE LAKES TO BE CONSISTENT WITH THE EXISTING DEVELOPMENT ORDERS AND PERMITS.

LEGEND

- 1 DEVIATION NUMBER
- INDIGENOUS OPEN SPACE

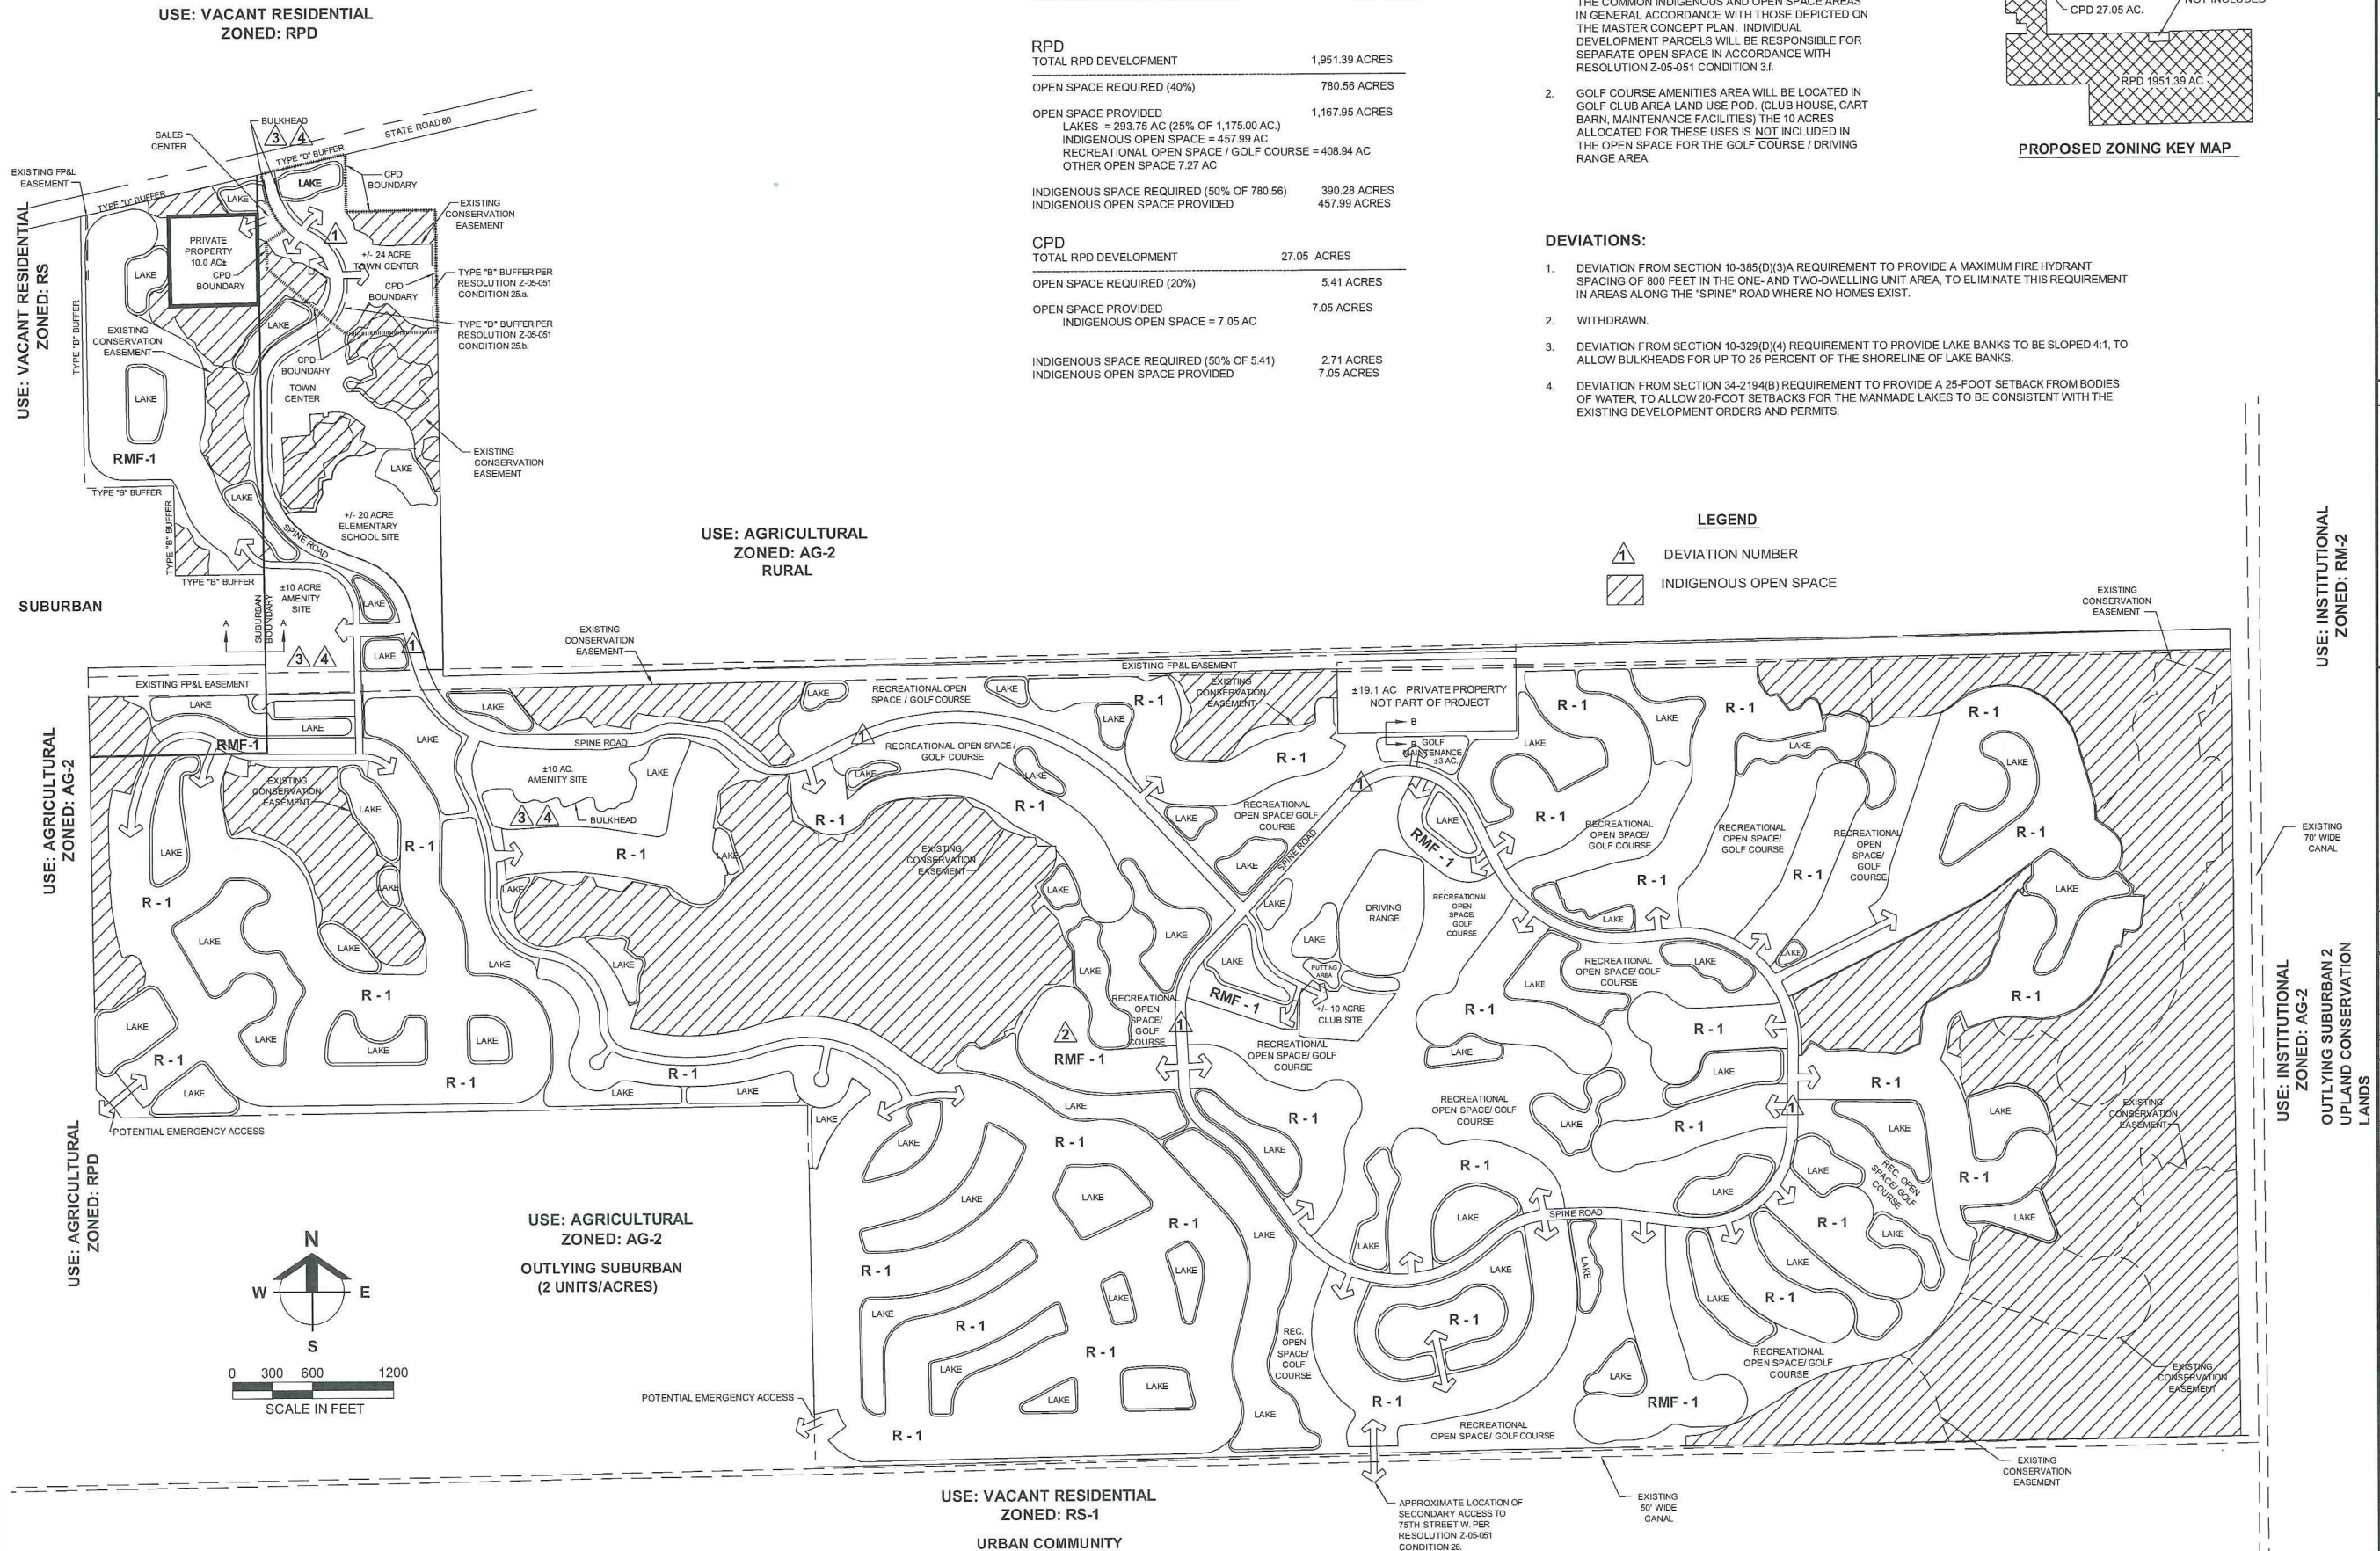

Barraco
and Associates, Inc.
CIVIL ENGINEERING - LAND SURVEYING
LAND PLANNING - LANDSCAPE DESIGN
www.barraco.net
2271 MCGREGOR BLVD., SUITE 100
FORT MYERS, FLORIDA 33902-2800
PHONE (239) 461-3170
FAX (239) 461-3169
FLORIDA CERTIFICATES OF AUTHORIZATION
ENGINEERING 7995 - SURVEYING LB-6940

PREPARED FOR
GREENPOINTE COMMUNITIES, LLC
7807 BAYMEADOWS ROAD E
SUITE 205
JACKSONVILLE, FL 32256
PHONE (904) 562-1358
FAX (904) 996-2461


PROJECT DESCRIPTION
RIVER HALL
FORMERLY KNOWN AS
HAWKS HAVEN
PART OF SECTIONS 27, 34, 35 AND 36
TOWNSHIP 43 SOUTH
RANGE 26 EAST
LEE COUNTY, FLORIDA

RECEIVED
JAN 30 2018
ADD2018-00058

DRAWING NOT VALID WITHOUT SEAL, SIGNATURE AND DATE.
© COPYRIGHT 2018 BARRACO AND ASSOCIATES, INC.
REPRODUCTION, CHANGES OR ASSIGNMENTS ARE PROHIBITED.
FILE NAME: 21988200.DWG
LOCATION: J:\21988.DWG\ZONING\2018 REZONING
PLOT DATE: TUE-6-29-2018 - 4:08 PM
PLOT BY: ANGELA WARD
CROSS REFERENCED DRAWINGS
BASEPLAN = 21988200.DWG


PLAN REVISIONS	
12-17-14	REVISED AMENIMENT AREA
1-23-15	
5-29-18	PER LEE COUNTY ADDED 2 SHEETS
PLAN STATUS	
PREVIOUSLY APPROVED MASTER CONCEPT PLAN	
PROJECT / FILE NO.	SHEET NUMBER
	2

PROPOSED
25' BUFFER CONSISTING OF:
3' BERM +/-
6' WALL
7 TREES PER 100 L.F. PLANTED AT MIN. 10' HT
30 SHRUBS PER 100 L.F. PLANTED AT MIN. 24" HT
AND MAINTAINED AT 36"

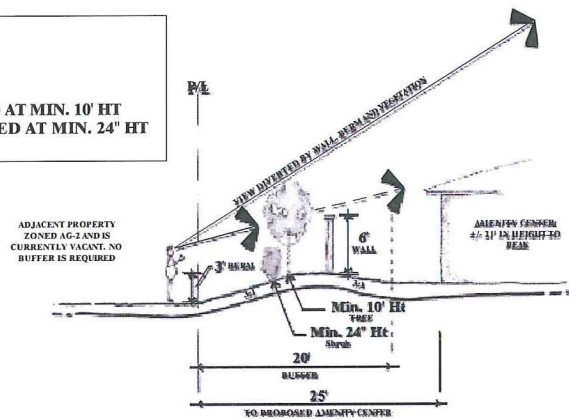

PROPOSED BUFFER FOR AMENITY CENTER (SECTION A-A)
NTS

PROPOSED
25' BUFFER CONSISTING OF:
4' BERM +/-
6' WALL
7 TREES PER 100 L.F. PLANTED AT MIN. 10' HT
30 SHRUBS PER 100 L.F. PLANTED AT MIN. 24" HT
AND MAINTAINED AT 36"

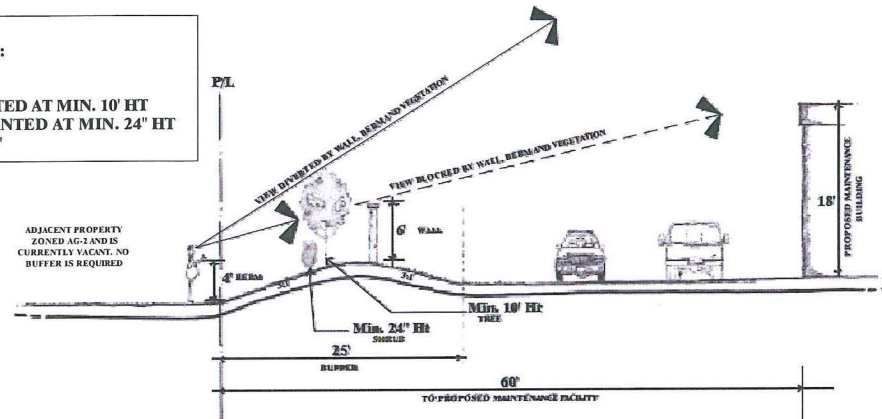

PROPOSED BUFFER FOR GOLF COURSE MAINTENANCE FACILITY (SECTION B-B)
NTS

Barraco
and Associates, Inc.
CIVIL ENGINEERING - LAND SURVEYING
LAND PLANNING - LANDSCAPE DESIGN
www.barraco.net
2271 MCGREGOR BLVD., SUITE 100
POST OFFICE DRAWER 2800
FORT MYERS, FLORIDA 33902-2800
PHONE (239) 461-3170
FAX (239) 461-3169
FLORIDA CERTIFICATES OF AUTHORIZATION
ENGINEERING 7995 - SURVEYING LB-6940

PREPARED FOR
GREENPOINTE COMMUNITIES, LLC
7807 BAYMEADOWS ROAD E
SUITE 205
JACKSONVILLE, FL 32256
PHONE (904) 562-1358
FAX (904) 996-2481

PROJECT DESCRIPTION
RIVER HALL
FORMERLY KNOWN AS
HAWKS HAVEN
PART OF SECTIONS 27, 34, 35 AND 36
TOWNSHIP 43 SOUTH
RANGE 26 EAST
LEE COUNTY, FLORIDA

DRAWING NOT VALID WITHOUT SEAL, SIGNATURE AND DATE
© COPYRIGHT 2018, BARRACO AND ASSOCIATES, INC.
REPRODUCTION, CHANGES OR ASSIGNMENTS ARE PROHIBITED

FILE NAME	21088202B.DWG
LOCATION	J:\21088202B\ZONING\2018 REZONE\
PLOT DATE	TUE, 5-29-2018 - 4:08 PM
PLOT BY	ANGELICA HARDY

CROSS REFERENCED DRAWINGS



PLAN REVISIONS	
12-17-14	REVISED AMENDMENT AREA
1-23-15	
5-29-18	PER LEE COUNTY ADDED 2 SHEETS

PLAN STATUS

PREVIOUSLY
APPROVED TYPICAL
SECTIONS

PROJECT / FILE NO.	SHEET NUMBER
.	3

RECEIVED
MAY 30 2018
COMMUNITY DEVELOPMENT
ADD2018-00058

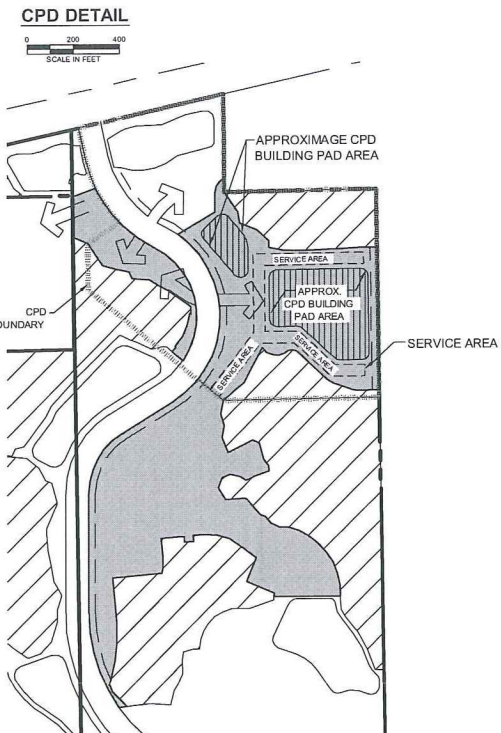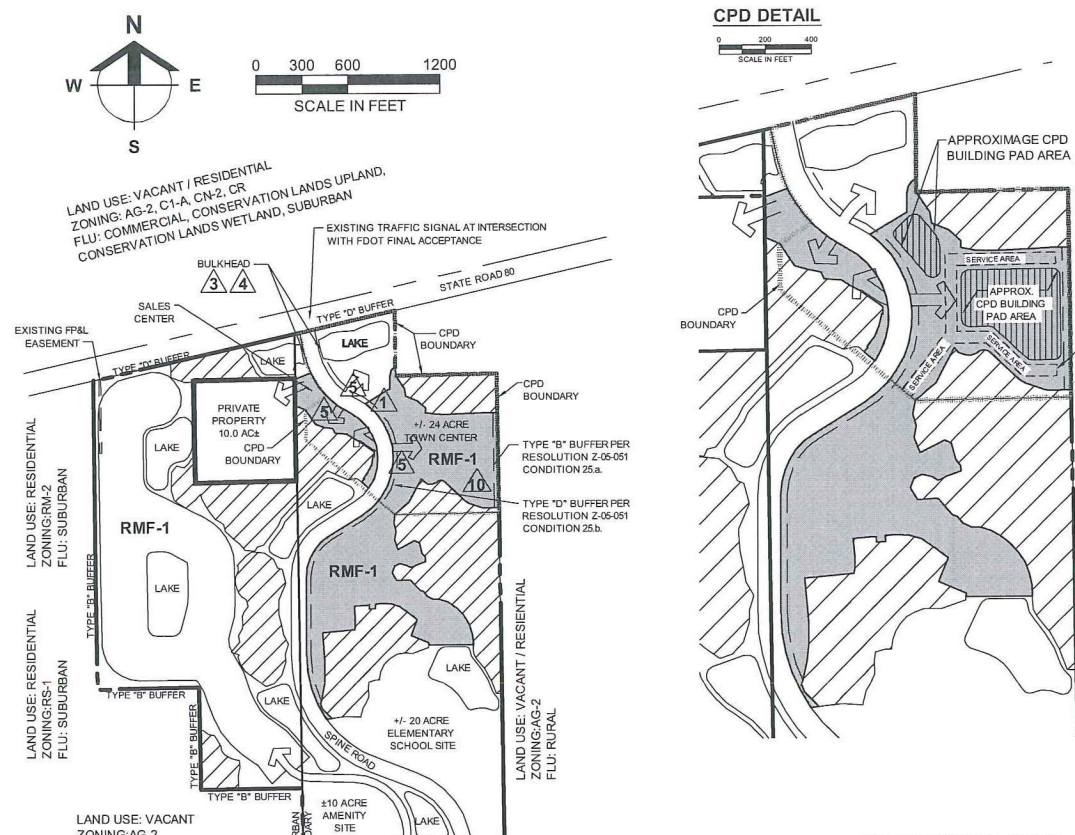

OPEN SPACE CALCULATIONS:

ENTIRE PROJECT	
TOTAL DEVELOPMENT	1,978.44 ACRES
OPEN SPACE PROVIDED	1,175.00 ACRES
INDIGENOUS OPEN SPACE PROVIDED	465.04 ACRES

RPD	
TOTAL RPD DEVELOPMENT	1,951.39 ACRES
OPEN SPACE REQUIRED (40%)	780.56 ACRES
OPEN SPACE PROVIDED	1,167.95 ACRES
LAKES = 293.75 AC (25% OF 1,175.00 AC.)	
INDIGENOUS OPEN SPACE = 457.99 AC	
RECREATIONAL OPEN SPACE / GOLF COURSE = 408.94 AC	
OTHER OPEN SPACE 7.27 AC	

INDIGENOUS SPACE REQUIRED (50% OF 780.56)	390.28 ACRES
INDIGENOUS OPEN SPACE PROVIDED	457.99 ACRES


CPD	
TOTAL CPD DEVELOPMENT	27.05 ACRES
OPEN SPACE REQUIRED (20%)	5.41 ACRES
OPEN SPACE PROVIDED	7.05 ACRES
INDIGENOUS OPEN SPACE = 7.05 AC	

INDIGENOUS SPACE REQUIRED (50% OF 5.41)	2.71 ACRES
INDIGENOUS OPEN SPACE PROVIDED	7.05 ACRES

NOTE:
MAXIMUM COMMERCIAL SQUARE FOOTAGE IN ACCORDANCE WITH Z-05-051
(45,000 SF MAXIMUM)

DEVIATIONS:

1. DEVIATION FROM SECTION 10-385(D)(3A) REQUIREMENT TO PROVIDE A MAXIMUM FIRE HYDRANT SPACING OF 800 FEET IN THE ONE- AND TWO-DWELLING UNIT AREA, TO ELIMINATE THIS REQUIREMENT IN AREAS ALONG THE "SPINE" ROAD WHERE NO HOMES EXIST.
2. WITHDRAWN.
3. DEVIATION FROM SECTION 10-329(D)(4) REQUIREMENT TO PROVIDE LAKE BANKS TO BE SLOPED 4:1, TO ALLOW BULKHEADS FOR UP TO 25 PERCENT OF THE SHORELINE OF LAKE BANKS.
4. DEVIATION FROM SECTION 34-2194(B) REQUIREMENT TO PROVIDE A 25-FOOT SETBACK FROM BODIES OF WATER, TO ALLOW 20-FOOT SETBACKS FOR THE MANMADE LAKES TO BE CONSISTENT WITH THE EXISTING DEVELOPMENT ORDERS AND PERMITS.
5. DEVIATION FROM SECTION 30-152(2)c TO ALLOW A REDUCTION IN THE MINIMUM SETBACK FROM RESIDENTIAL SUBDIVISION ENTRANCE SIGNAGE FROM 15 FEET TO 5 FEET FROM THE RIGHT-OF-WAY.
6. DEVIATION FROM LDC SECTION 10-415(b)(1)c WHICH REQUIRES A MINIMUM SETBACK OF 20 FEET FROM BUILDINGS AND A 30 FOOT SETBACK FOR INDIGENOUS PLANT COMMUNITIES SUBJECT TO FIRE TO ALLOW A SIDE SETBACK OF 17 FEET FOR THE FOLLOWING EXISTING PLATTED LOTS: RIVER HALL COUNTRY CLUB, PHASE TWO, BLOCK K, LOTS 29, 57, 76 AND 77; HAMPTON LAKES AT RIVER HALL, PHASE ONE, LOT 87.
7. DEVIATION FROM LDC SECTION 10-415(b)(1)c WHICH REQUIRES A MINIMUM SETBACK OF 20 FEET FROM BUILDINGS AND A 30 FOOT SETBACK FOR INDIGENOUS PLANT COMMUNITIES SUBJECT TO FIRE TO ALLOW A REAR SETBACK OF 20 FEET FOR ALL EXISTING PLATTED LOTS.
8. WITHDRAWN
9. WITHDRAWN
10. DEVIATION FROM LDC SECTION 34-394 WHICH PERMITS DWELLING UNITS WITHIN A CPD WHEN THERE ARE AT LEAST 50,000 SQUARE FEET OR MORE OF COMMERCIAL USES TO ALLOW DWELLING UNITS WITHIN THE EXISTING RIVER HALL CPD WHICH WAS PERMITTED FOR 45,000 SQUARE FEET OF COMMERCIAL USES.

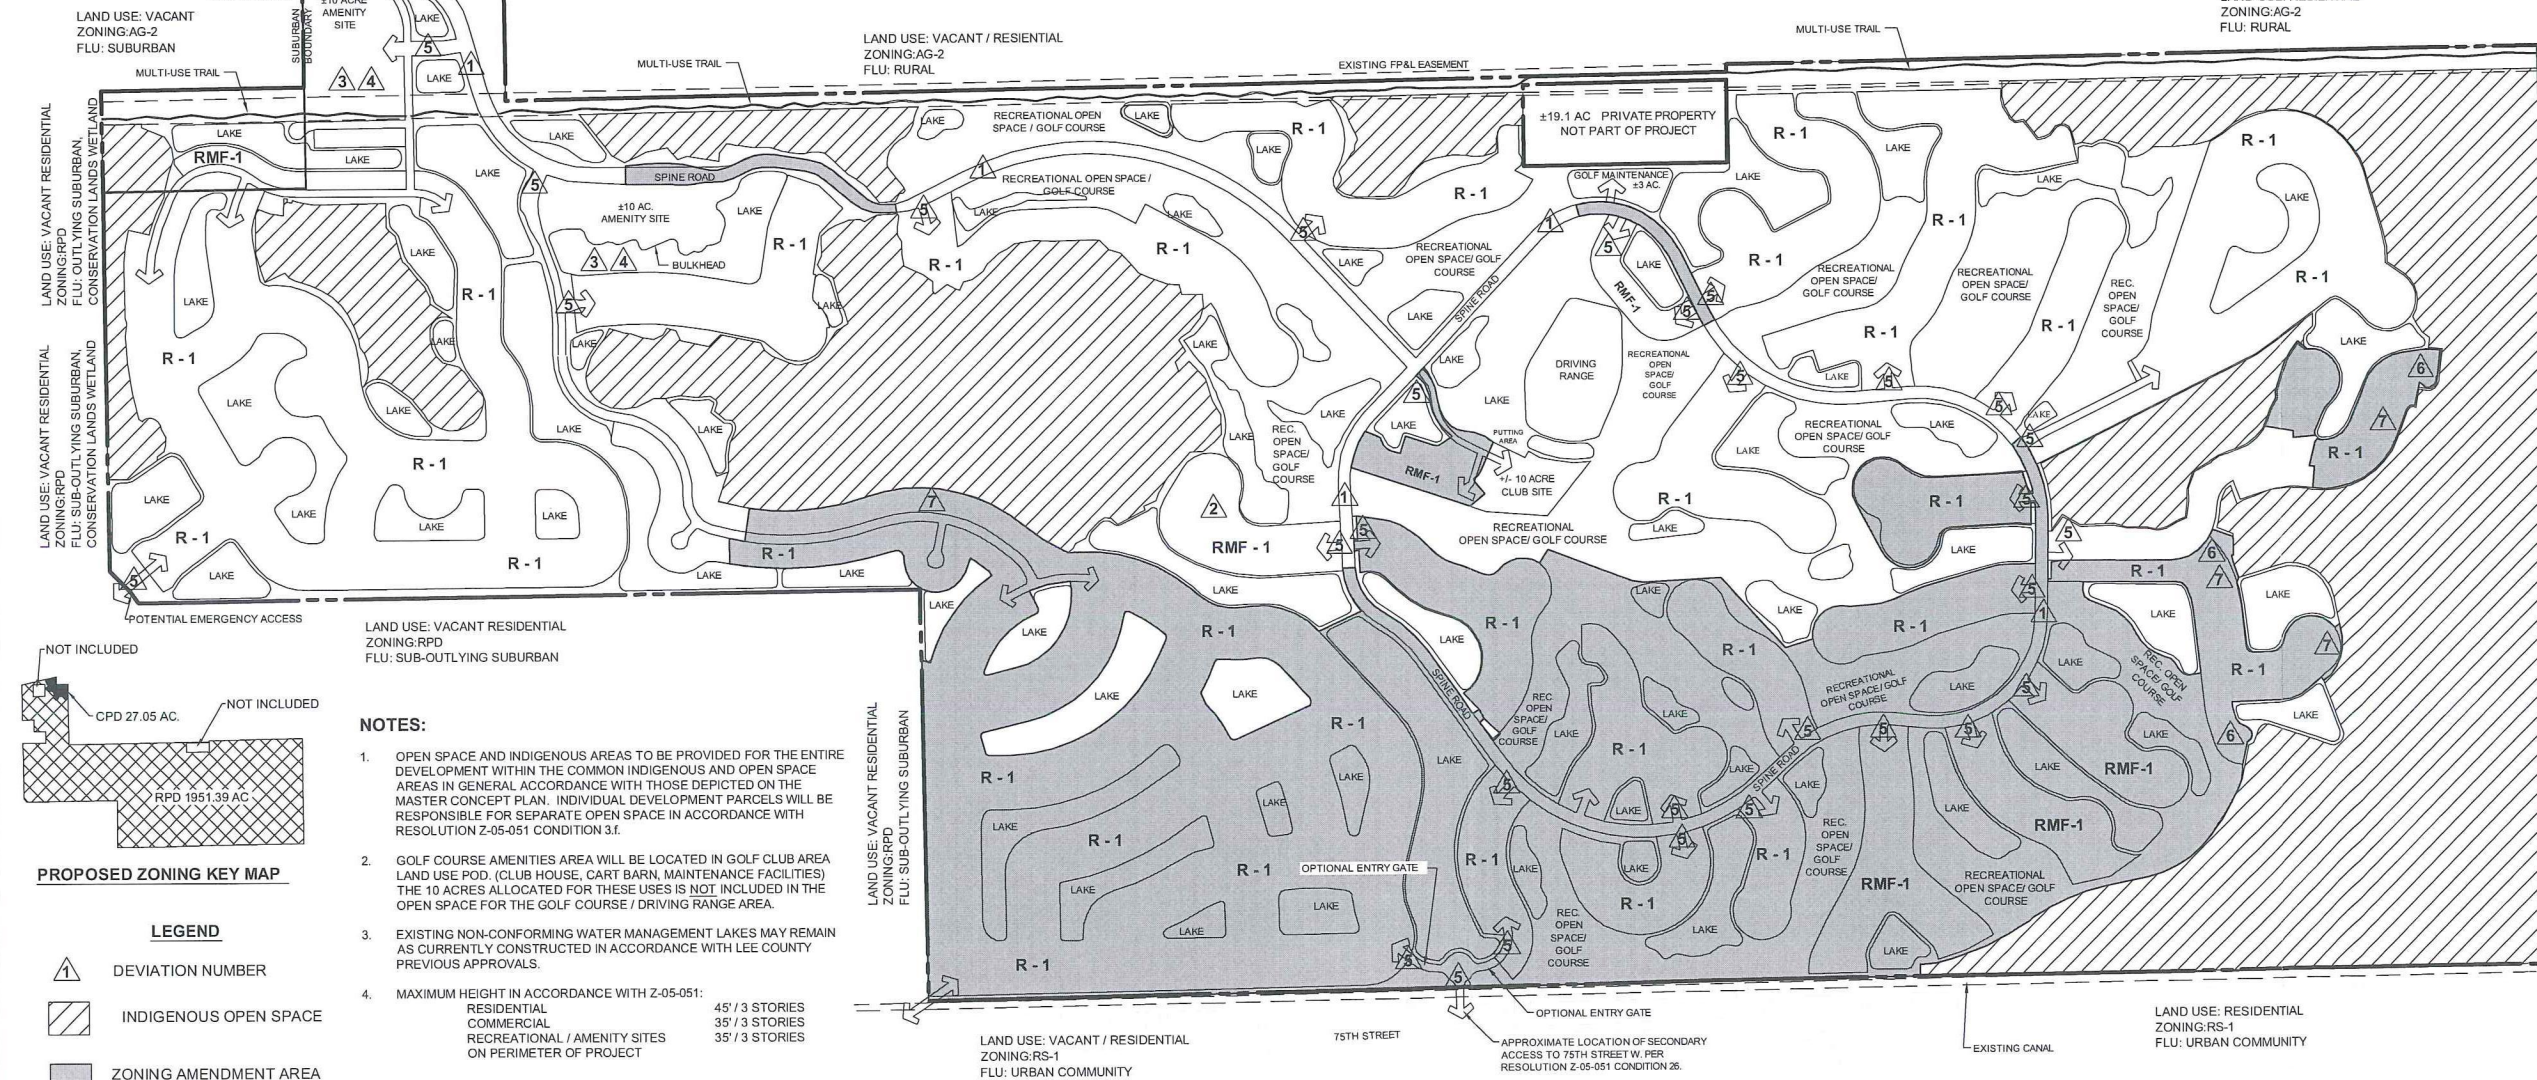

LAND USE: VACANT / PRESERVE
ZONING: TFC-2
FLU: CONSERVATION LANDS UPLAND

LAND USE: VACANT / PRESERVE
ZONING: AG-2
FLU: CONSERVATION LANDS UPLAND

RECEIVED
MAY 30 2018
COMMUNITY DEVELOPMENT

CROSS REFERENCED DRAWINGS




BASEPLAN = 21988Z00.DWG

PLAN REVISIONS	
1-2-12	NOTE CHANGES
4-1-13	REVISED AMENDMENT AREA
7-19-13	NOTE CHANGES
9-12-13	REVISED AMENDMENT AREA
1-5-14	
1-23-15	REVISED PER HEX
2-15-18	TRAFFIC SIGNAL ADDED
5-29-18	PER LEE COUNTY ADDED 2 SHEETS

PLAN STATUS

MASTER
CONCEPT
PLAN

PROJECT / FILE NO.	SHEET NUMBER
.	4

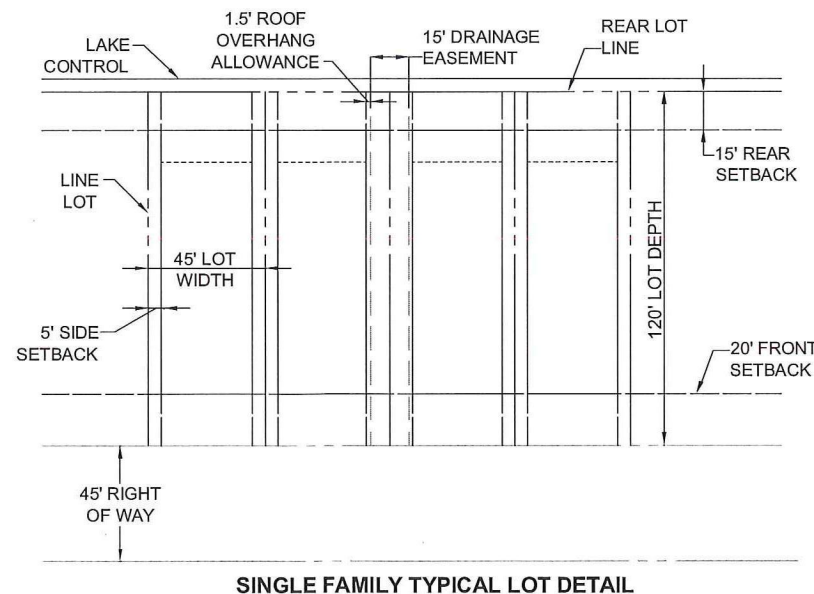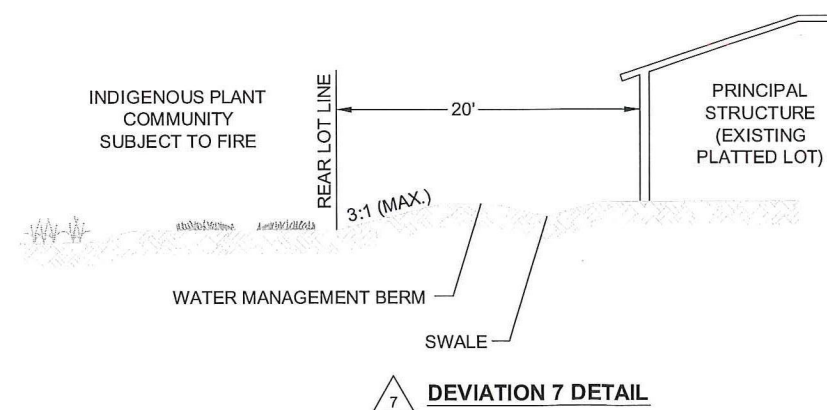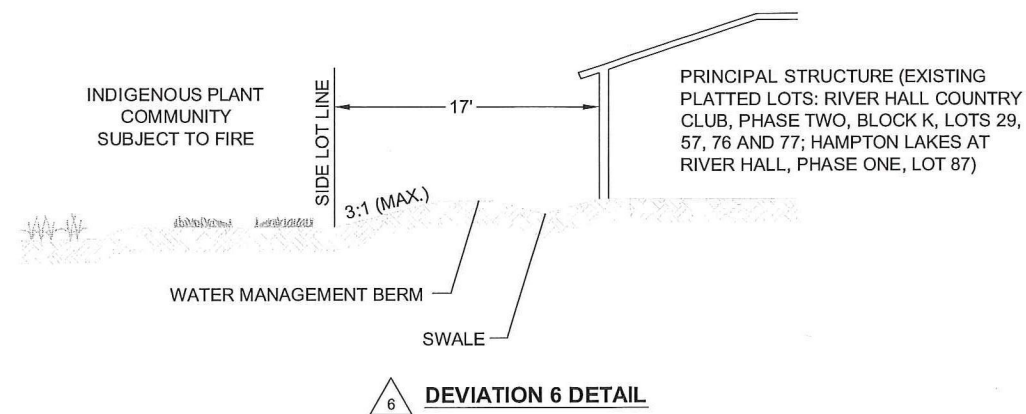

SITE DEVELOPMENT REGULATIONS

MINIMUM LOT AREA AND DIMENSIONS - SINGLE FAMILY

WIDTH: 45 FEET
DEPTH: 120 FEET
LOT SIZE: 5,400 S.F.

MINIMUM SETBACKS

SINGLE FAMILY

ROAD: PALM BEACH BLVD 25 FEET / PRIVATE ROADS 20 FEET
SIDE: 5 FEET, SEE CONDITION 2.b.i.
REAR: 15 FEET
WATERBODY: 20 FEET
ACCESSORY: 5 FEET

MAXIMUM LOT COVERAGE - 60 PERCENT

2.b.i. STRUCTURES, INCLUDING BUT NOT LIMITED TO, SIDEWALKS, AIR CONDITIONERS, MECHANICAL EQUIPMENT, DOOR STOOPS, WALLS, etc. MAY NOT BE LOCATED WITHIN THE REQUIRED 5-FOOT SIDE SETBACK OF EACH LOT. PRIOR TO ISSUANCE OF CERTIFICATE OF OCCUPANCY ON EACH LOT, THE ENGINEER OF RECORD MUST CERTIFY THAT THE DRAINAGE FOR EACH LOT IS BUILT IN COMPLIANCE WITH THE TYPICAL LOT GRADING DETAIL PROVIDED.

Barraco
and Associates, Inc.
CIVIL ENGINEERING - LAND SURVEYING
LAND PLANNING - LANDSCAPE DESIGN
www.barraco.net
2271 MCGREGOR BLVD., SUITE 100
FORT MYERS, FLORIDA 33902-2800
PHONE (239) 461-3170
FAX (239) 461-3169
FLORIDA CERTIFICATES OF AUTHORIZATION
ENGINEERING 7995 - SURVEYING LB-6940

PREPARED FOR

GREENPOINTE COMMUNITIES, LLC
7807 BAYMEADOWS ROAD E
SUITE 205
JACKSONVILLE, FL 32256
PHONE (904) 562-1358
FAX (904) 996-2481

PROJECT DESCRIPTION

RIVER HALL
FORMERLY KNOWN AS
HAWKS HAVEN
PART OF SECTIONS 27, 34, 35 AND 36
TOWNSHIP 43 SOUTH
RANGE 26 EAST
LEE COUNTY, FLORIDA

RECEIVED
MAY 30 2018
COMMUNITY DEVELOPMENT

FILE NAME: 21988203.DWG
LOCATION: J:\21988\DWG\ZONING\2018 REZONE\1
PLOT DATE: TUE. 5-29-2018 - 4:09 PM
PLOT BY: ANGELICA HARDY

CROSS REFERENCED DRAWINGS

PLAN REVISIONS

DATE	REVISION
3-20-13	REVISED AMENDMENT AREA
12-17-14	REVISED AMENDMENT AREA
1-23-15	REVISED PER HEX
2-15-18	TRAFFIC SIGNAL ADDED
5-29-18	PER LEE COUNTY ADDED 2 SHEETS

PLAN STATUS

PROPOSED DETAILS

PROJECT / FILE NO.	SHEET NUMBER
	5